



Wildlife and Countryside Act 1981

County of Dorset Definitive Map and Statement of Rights of Way

**Dorset County Council (Upgrading of Bridleway 9, Winfrith Newburgh and ~~Part of~~
~~Bridleway 5, Coombe Keynes (Claypits Lane) to Restricted Byways~~)
Definitive Map and Statement Modification Order 2011**

This Order is made by Dorset County Council under section 53(2)(b) of the Wildlife and Countryside Act 1981 ("the Act") because it appears to that authority that the County of Dorset Definitive Map and Statement require modification in consequence of the occurrence of an event specified in section 53(3)(c)(ii) namely, that a highway shown in the map and statement as a highway of a particular description ought to be there shown as a highway of a different description and section 53(3)(c)(iii) that any other particulars contained in the map and statement require modification.

The authority have consulted with every local authority whose area includes the land to which the order relates. The Dorset County Council hereby order that:

1. For the purposes of this order the relevant date is 3 June 2011.
2. The County of Dorset Definitive Map and Statement shall be modified as described in Part I and Part II of the Schedule and shown on the map attached to the Order.
3. This order shall take effect on the date it is confirmed and may be cited as the "Dorset County Council (Upgrading of Bridleway 9, Winfrith Newburgh and ~~Part of~~
~~Bridleway 5, Coombe Keynes (Claypits Lane) to Restricted Byways~~) Definitive Map and Statement Modification Order 2011".



SCHEDULE

PART I

Modification of definitive map Description of ways to be upgraded

~~Bridleway 9, Winfrith Newburgh and part of Bridleway 5, Coombe Keynes known as Claypits Lane in the Purbeck District to be upgraded to Restricted Byway: -~~

Bridleway 9, Winfrith Newburgh (to become Restricted Byway 9, Winfrith Newburgh)

From its junction with the unclassified road east of the village of Winfrith Newburgh at Claypits Farm at point A (SY 81478480), east along Claypits Lane, an unsurfaced double hedged lane, to point B (SY 81648481) and then east with a grassed surface along the northern side of the field boundary to point C (SY 81748482) and across the open field to point D (SY 82088482). Continue east along an unsurfaced double hedged lane, passing through Newburgh Dairy, to the parish boundary with Coombe Keynes at point E (SY 82758477).

The width of the restricted byway varies:

Point A - 4 metres, widening to 4.3 metres at point B.

Between points B and C and D - 4 metres

Point D - 6 metres

Between points D and E - 4.6 metres

Point E - 5 metres

~~Part of Bridleway 5, Coombe Keynes (to become Restricted Byway 6, Coombe Keynes)~~

~~From its junction with the Winfrith Newburgh Parish boundary at point E (SY 82758477), east with a grassed surface, on the southern side of the northern field boundary to the western edge of Coombe Wood at point F (SY 83158485).~~

~~The width of the restricted byway varies:~~

~~Point E - 5 metres~~

~~Between points E and F - 4 metres~~

~~Point F - 3.1 metres~~

PART II

Modification of definitive statement Variation of particulars of ways

Delete:

Bridleway 9, Winfrith Newburgh

From: 815848

To: 827847

Claypits Lane east to Coombe Keynes parish boundary

Add:

Restricted Byway 9, Winfrith Newburgh

From: SY 81478480

To: SY 82758477

From its junction with the unclassified road east of the village of Winfrith Newburgh at Claypits Farm, east along Claypits Lane, an unsurfaced double hedged lane, to SY 81648481 and then

east with a grassed surface along the northern side of the field boundary to SY 81748482 and across the open field to SY 82088482. Continue east along an unsurfaced double hedged lane, passing through Newburgh Dairy, to the parish boundary with Coombe Keynes.

The width of the restricted byway varies:

SY 81478480 - 4 metres, widening to 4.3 metres at SY 81648481.

Between SY 81648481 and SY 81748482 and SY 82088482 - 4 metres

SY 82088482 6 metres

Between SY 82088482 and SY 82758477 - 4.6 metres

SY 82758477 - 5 metres

~~Delete:~~

~~Bridleway 5, Coombe Keynes~~

~~From: 841845 To: 827847~~

~~Coombe Keynes westwards via Coombe Wood to Winfrith parish boundary.~~

~~Add:~~

~~Bridleway 5, Coombe Keynes~~

~~From: SY 84088451 To: SY 83158485~~

~~Coombe Keynes westwards via Coombe Wood to its junction with Restricted Byway 6 at the western edge of Coombe Wood.~~

~~Add:~~

~~Restricted Byway 6, Coombe Keynes~~

~~From: SY 82758477 To: SY 83158485~~

~~From its junction with the Winfrith Newburgh Parish boundary, east, on the southern side of the northern field boundary to the western edge of Coombe Wood.~~

~~The width of the restricted byway varies:~~

~~SY 82758477 - 5 metres~~

~~Between SY 82758477 and SY 83158485 - 4 metres~~


~~SY 83158485 - 3.1 metres~~

Dated this 3 day of June 2011.

THE COMMON SEAL OF THE
DORSET COUNTY COUNCIL
was fixed in the presence of:-

Christ Taylor

Authorised Signatory

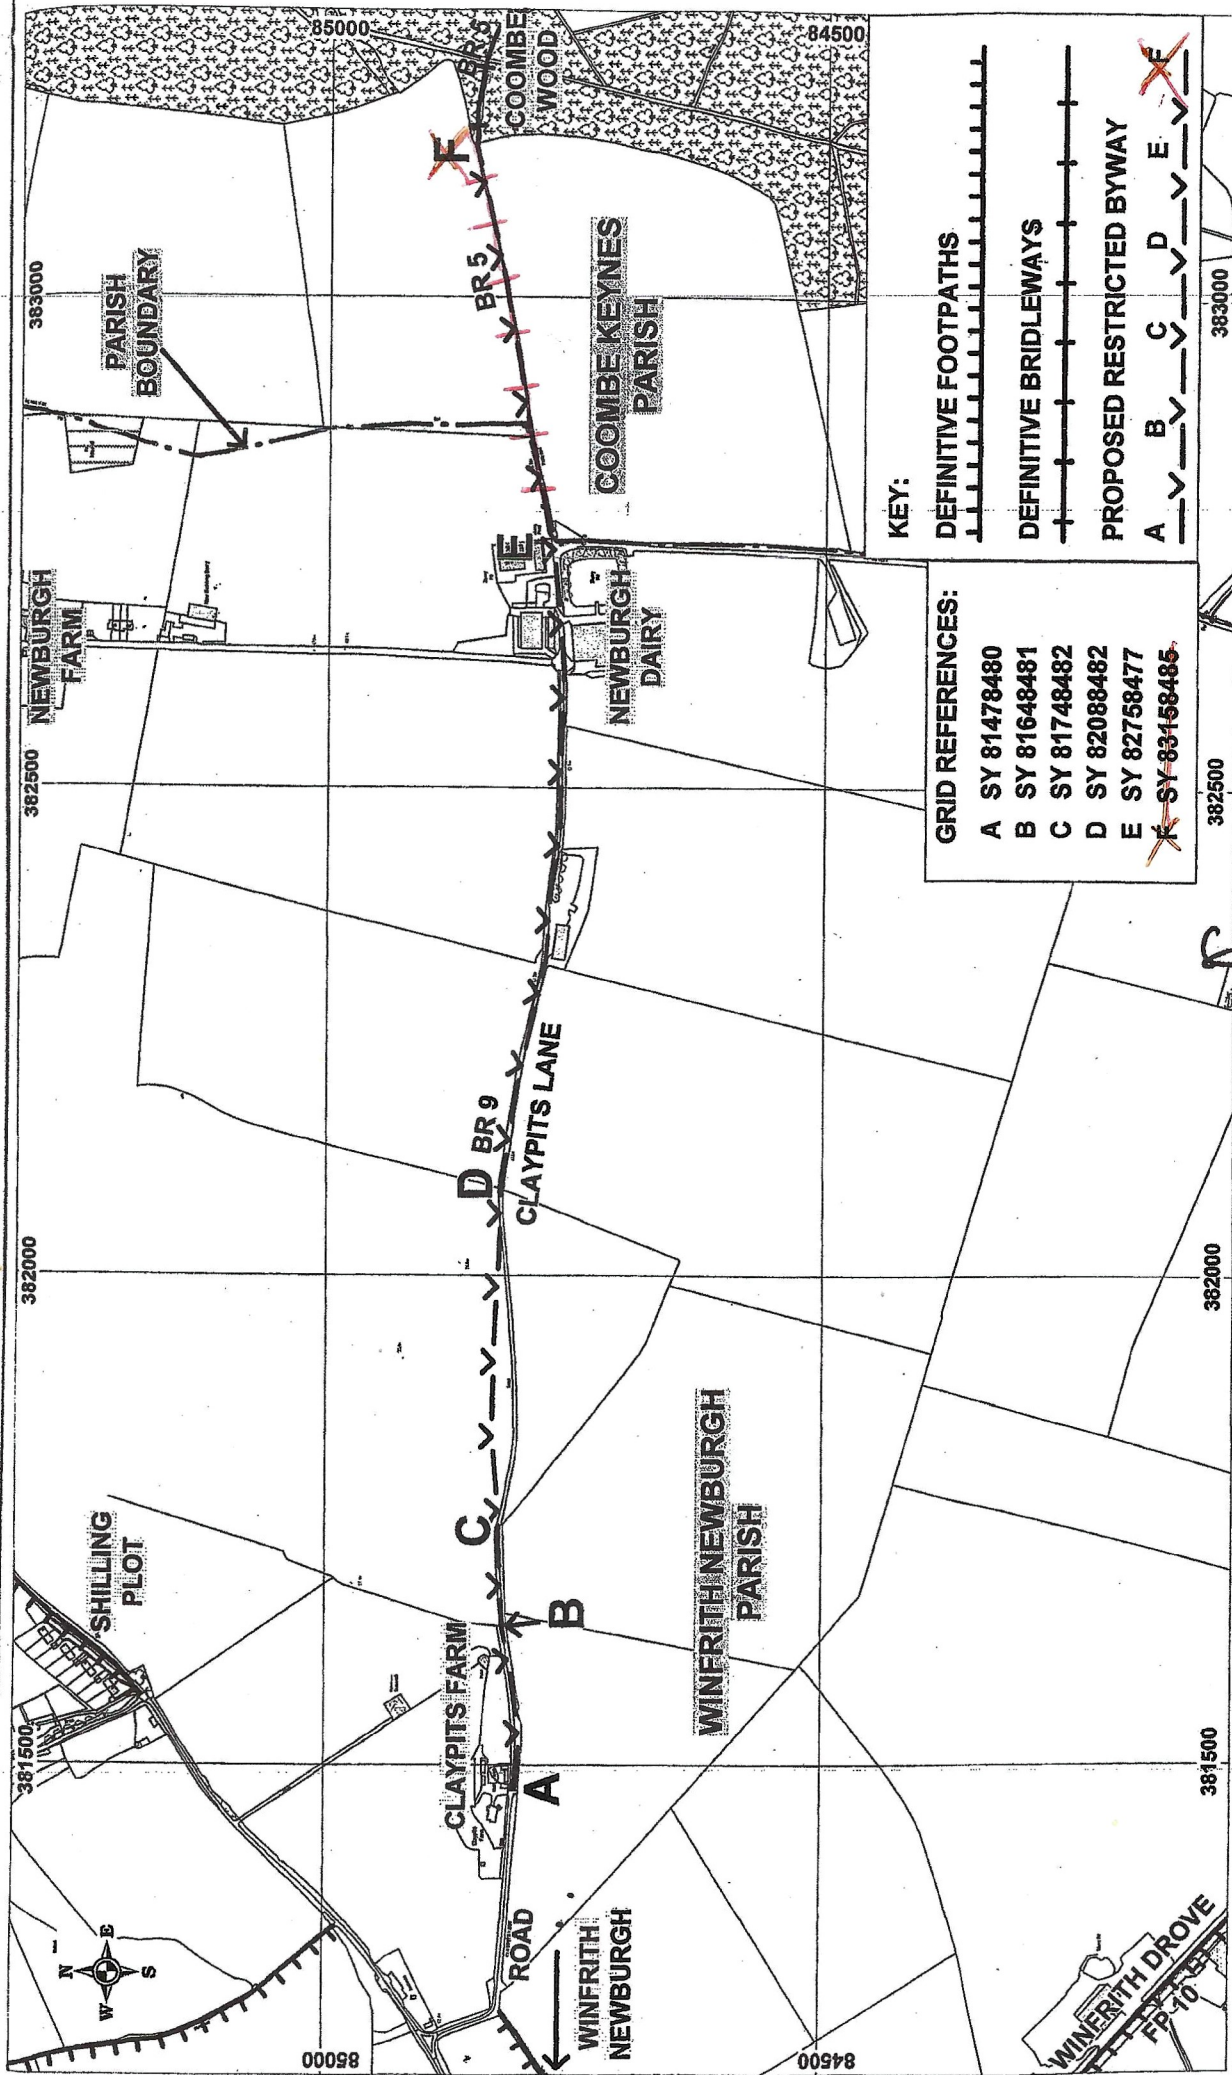

GRID REFERENCES:

A SY 81478480
 B SY 81648481
 C SY 81748482
 D SY 82088482
 E SY 82758477
~~K SY 83158485~~

KEY:

DEFINITIVE FOOTPATHS
 DEFINITIVE BRIDLEWAYS
 PROPOSED RESTRICTED BYWAY
 A B C D E ~~F~~



Ref: 10/04/2
 Date: 06/05/2011
 Scale 1:7500
 Drawn By: JLC
 Cent X: 382237
 Cent Y: 84703

WILDLIFE AND COUNTRYSIDE ACT 1981
 PROPOSED UPGRADING TO RESTRICTED BYWAY
 BRIDLEWAY 9, WINFRITH NEWBURGH AND PART OF BRIDLEWAY 5, COOMBE KEYNES
 CLAYPITS LANE

[Handwritten signature]

GEOGRAPHICAL INFORMATION SYSTEMS
 © UK Perspectives 2002 & © Geomatics 2005 & 2009
 © Crown Copyright (2011), OS Licence Number: 100019790